W5
W4
W4
W3
W3

## H.M.A.S. WESTRALIA

AS FITTED PROFILE

MODIFICATIONS SHOWN IN RED

DRG. Nº 10974/96A

SCALE $\frac{1}{16}$" = 1 FOOT

G.I. REGD. Nº 261/70

SHEET 1.

SECRET

NAVAL OVERSEER -3 APR 1940 MORT'S DOCK

H.M.A. NAVAL YARD GARDEN ISLAND 17 APR 1940 CONSTRUCTOR AND HULL OVERSEER

GENERAL OVERSEER

120/135 As Fitted

MORT'S DOCK & ENG Cº LTD SYDNEY

H.M.A.S. WESTRALIA

AS FITTED RIGGING PLAN.

| ORDER Nº | DATE | APPROVED | DRAWN | SCALE | DRAWING Nº | DRAWER |
|---|---|---|---|---|---|---|
| WESTRALIA. | 14-2-40 | | TRACED / CHECKED | $\frac{1}{16}$" = 1 FOOT | 10974/96A | 231 |

National Archives of Australia

NAA: MP551/1, 120/135/8

# H.M.A.S. WESTRALIA.

## As Fitted General Arrangement

Modifications Shown in Red
Drg No 10974/96B
Scale 1/16" = 1 Foot

G.I. Regd No 261/70
Sheet 2

[redacted]

NAVAL OVERSEER
3 APR 1940
MORT'S DOCK

H.M.A. NAVAL YARD
GARDEN ISLAND
17 APR 1940
CONSTRUCTOR
AND HULL OVERSEER

GENERAL OVERSEER

120/135. As Fitted.

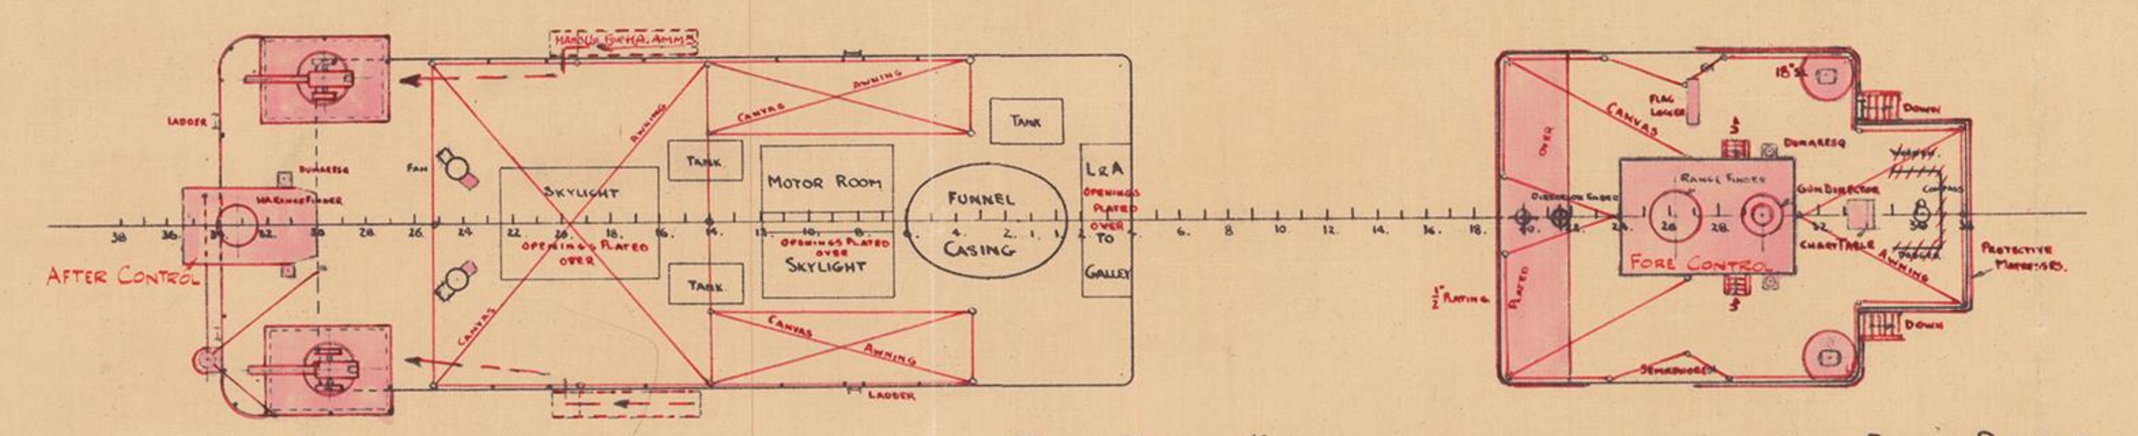


Top of Engineer's House

Flying Bridge

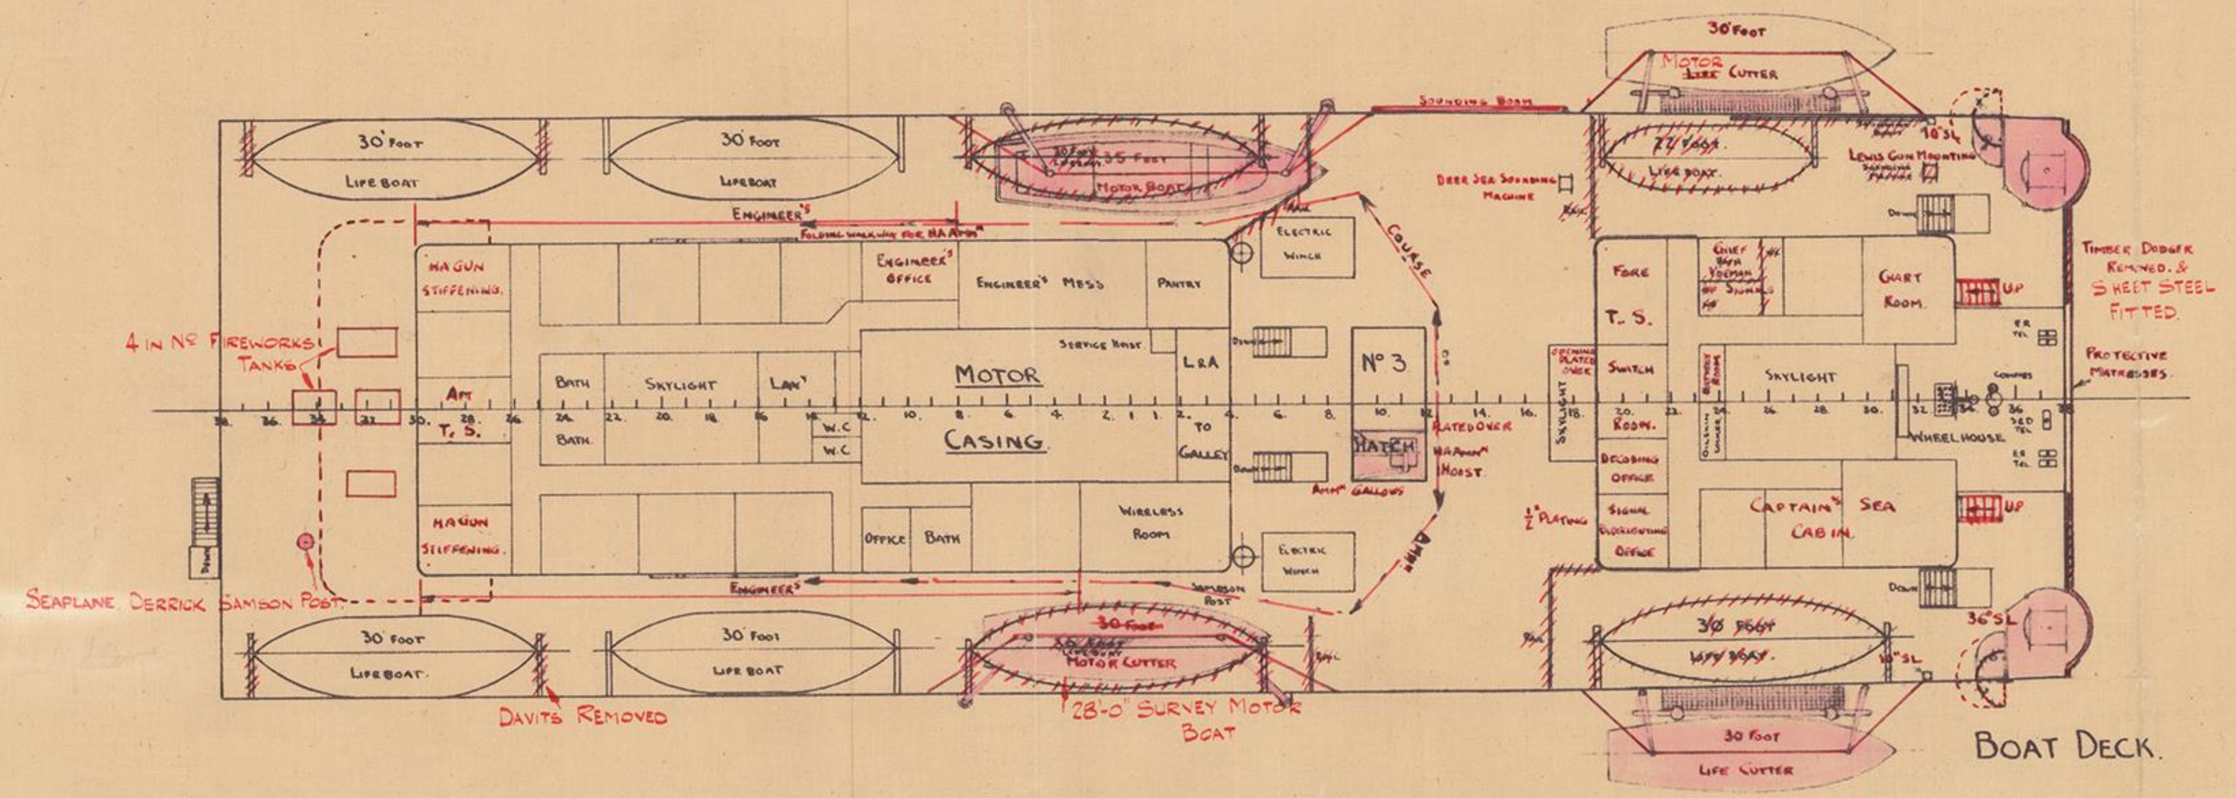


Boat Deck

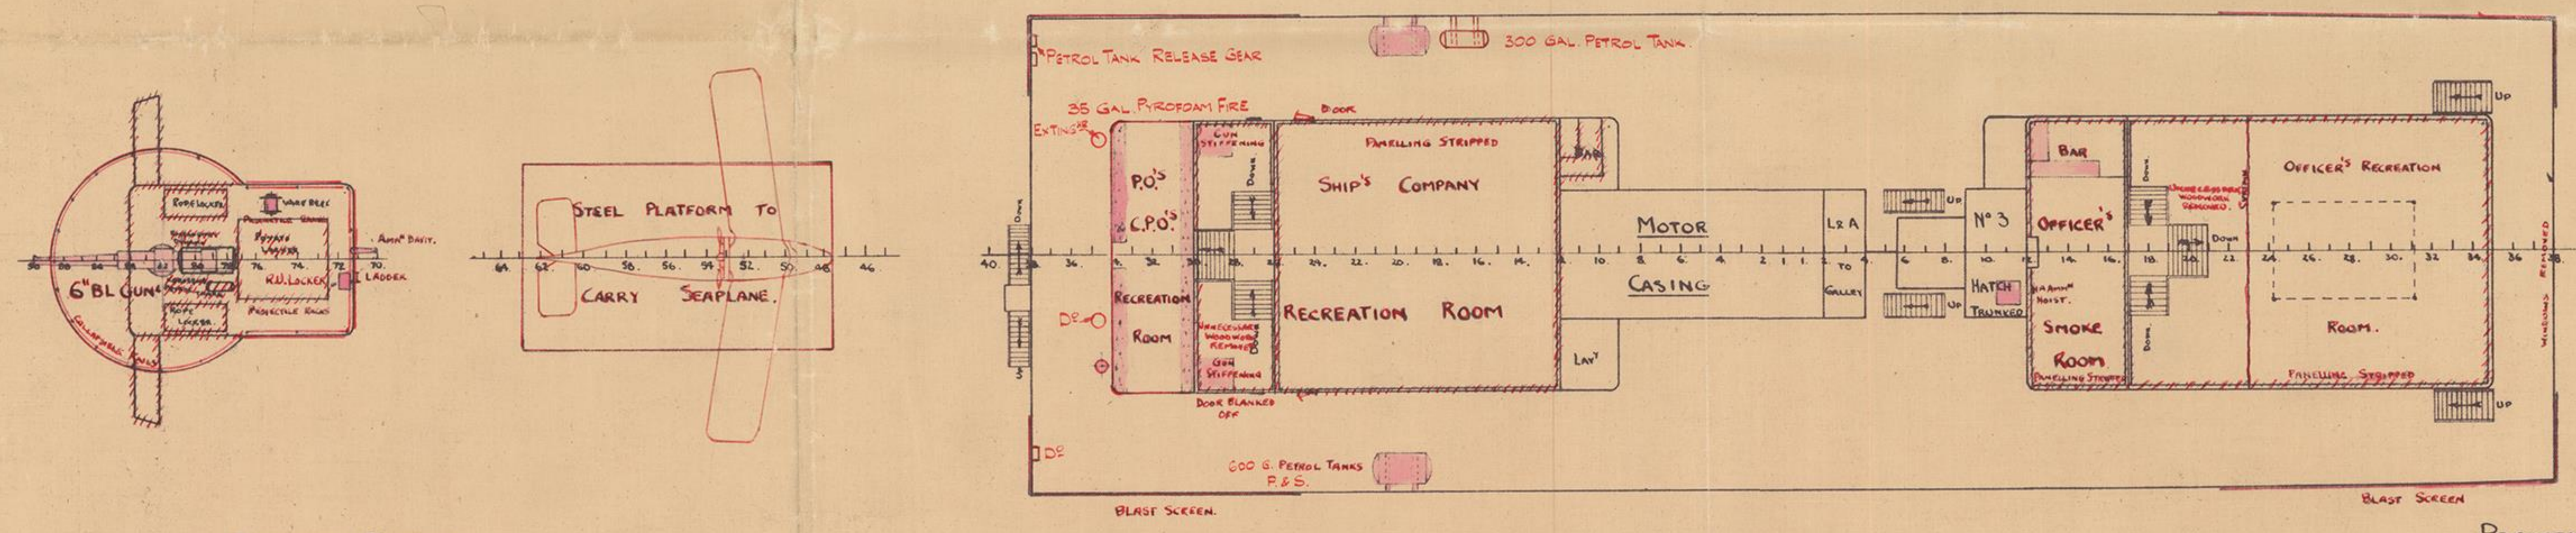


Docking Bridge

Promenade Deck

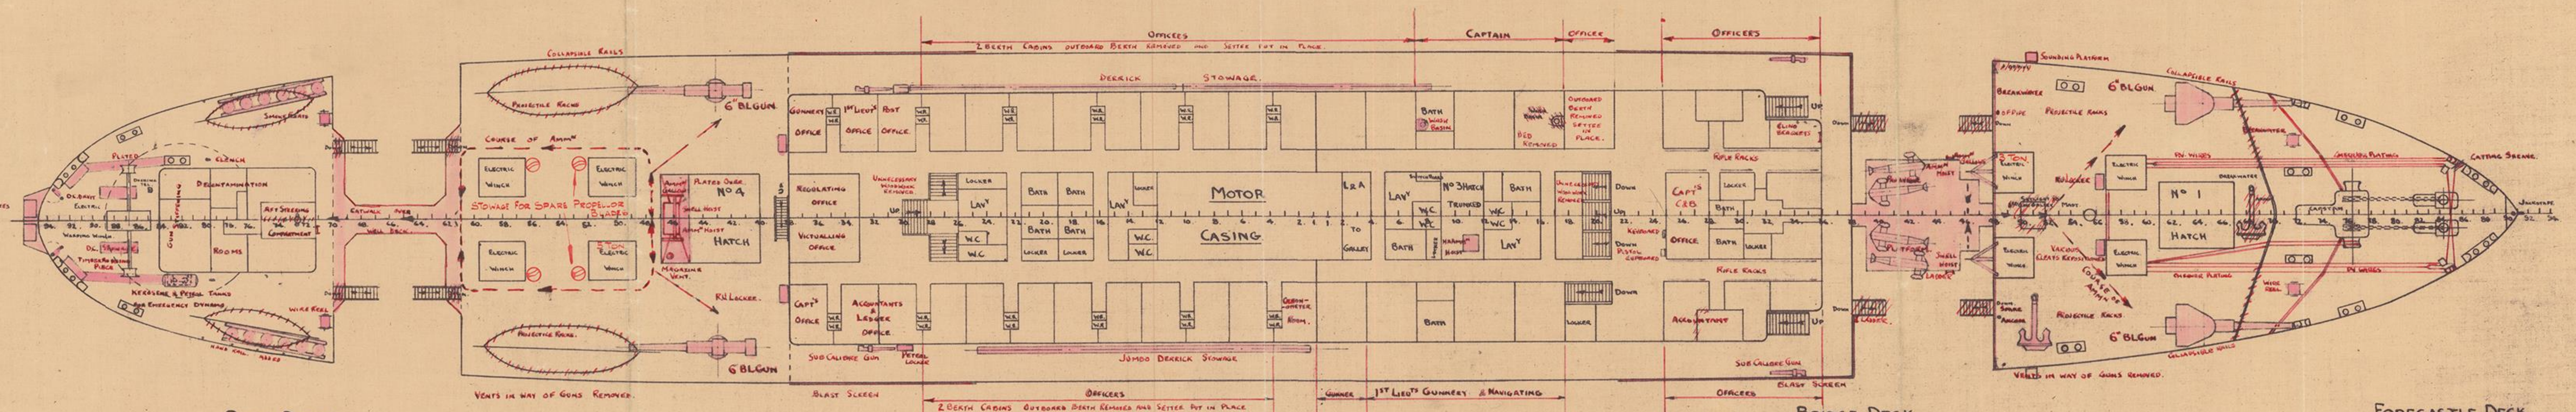


Poop Deck

Bridge Deck

Forecastle Deck

MORT'S DOCK & ENG Co Ltd SYDNEY
H.M.A.S. WESTRALIA
AS FITTED GENERAL ARRANGEMENT

| Order No | Date | Approved | Drawn / Traced / Checked | Scale | Drawing No | Drawer |
|---|---|---|---|---|---|---|
| WESTRALIA | 14-2-40 | | | 1/16" = 1 Foot | 10974/96B | 231 |

National Archives of Australia
NAA: MP551/1, 120/135/2

**H.M.A.S. WESTRALIA.**

**AS FITTED GENERAL ARRANGEMENT**

MODIFICATIONS SHOWN IN RED
DRG No 10974/96B
SCALE 1/16" - 1FOOT

G.I. REGD No 261/70.
SHEET 2

NAVAL OVERSEER
APR 1940
MORT'S DOCK

**SECRET.**

H.M.A. NAVAL YARD
GARDEN ISLAND
17 APR 1940
CONSTRUCTOR
AND HULL OVERSEER

GENERAL OVERSEER

120/135 As Fitted

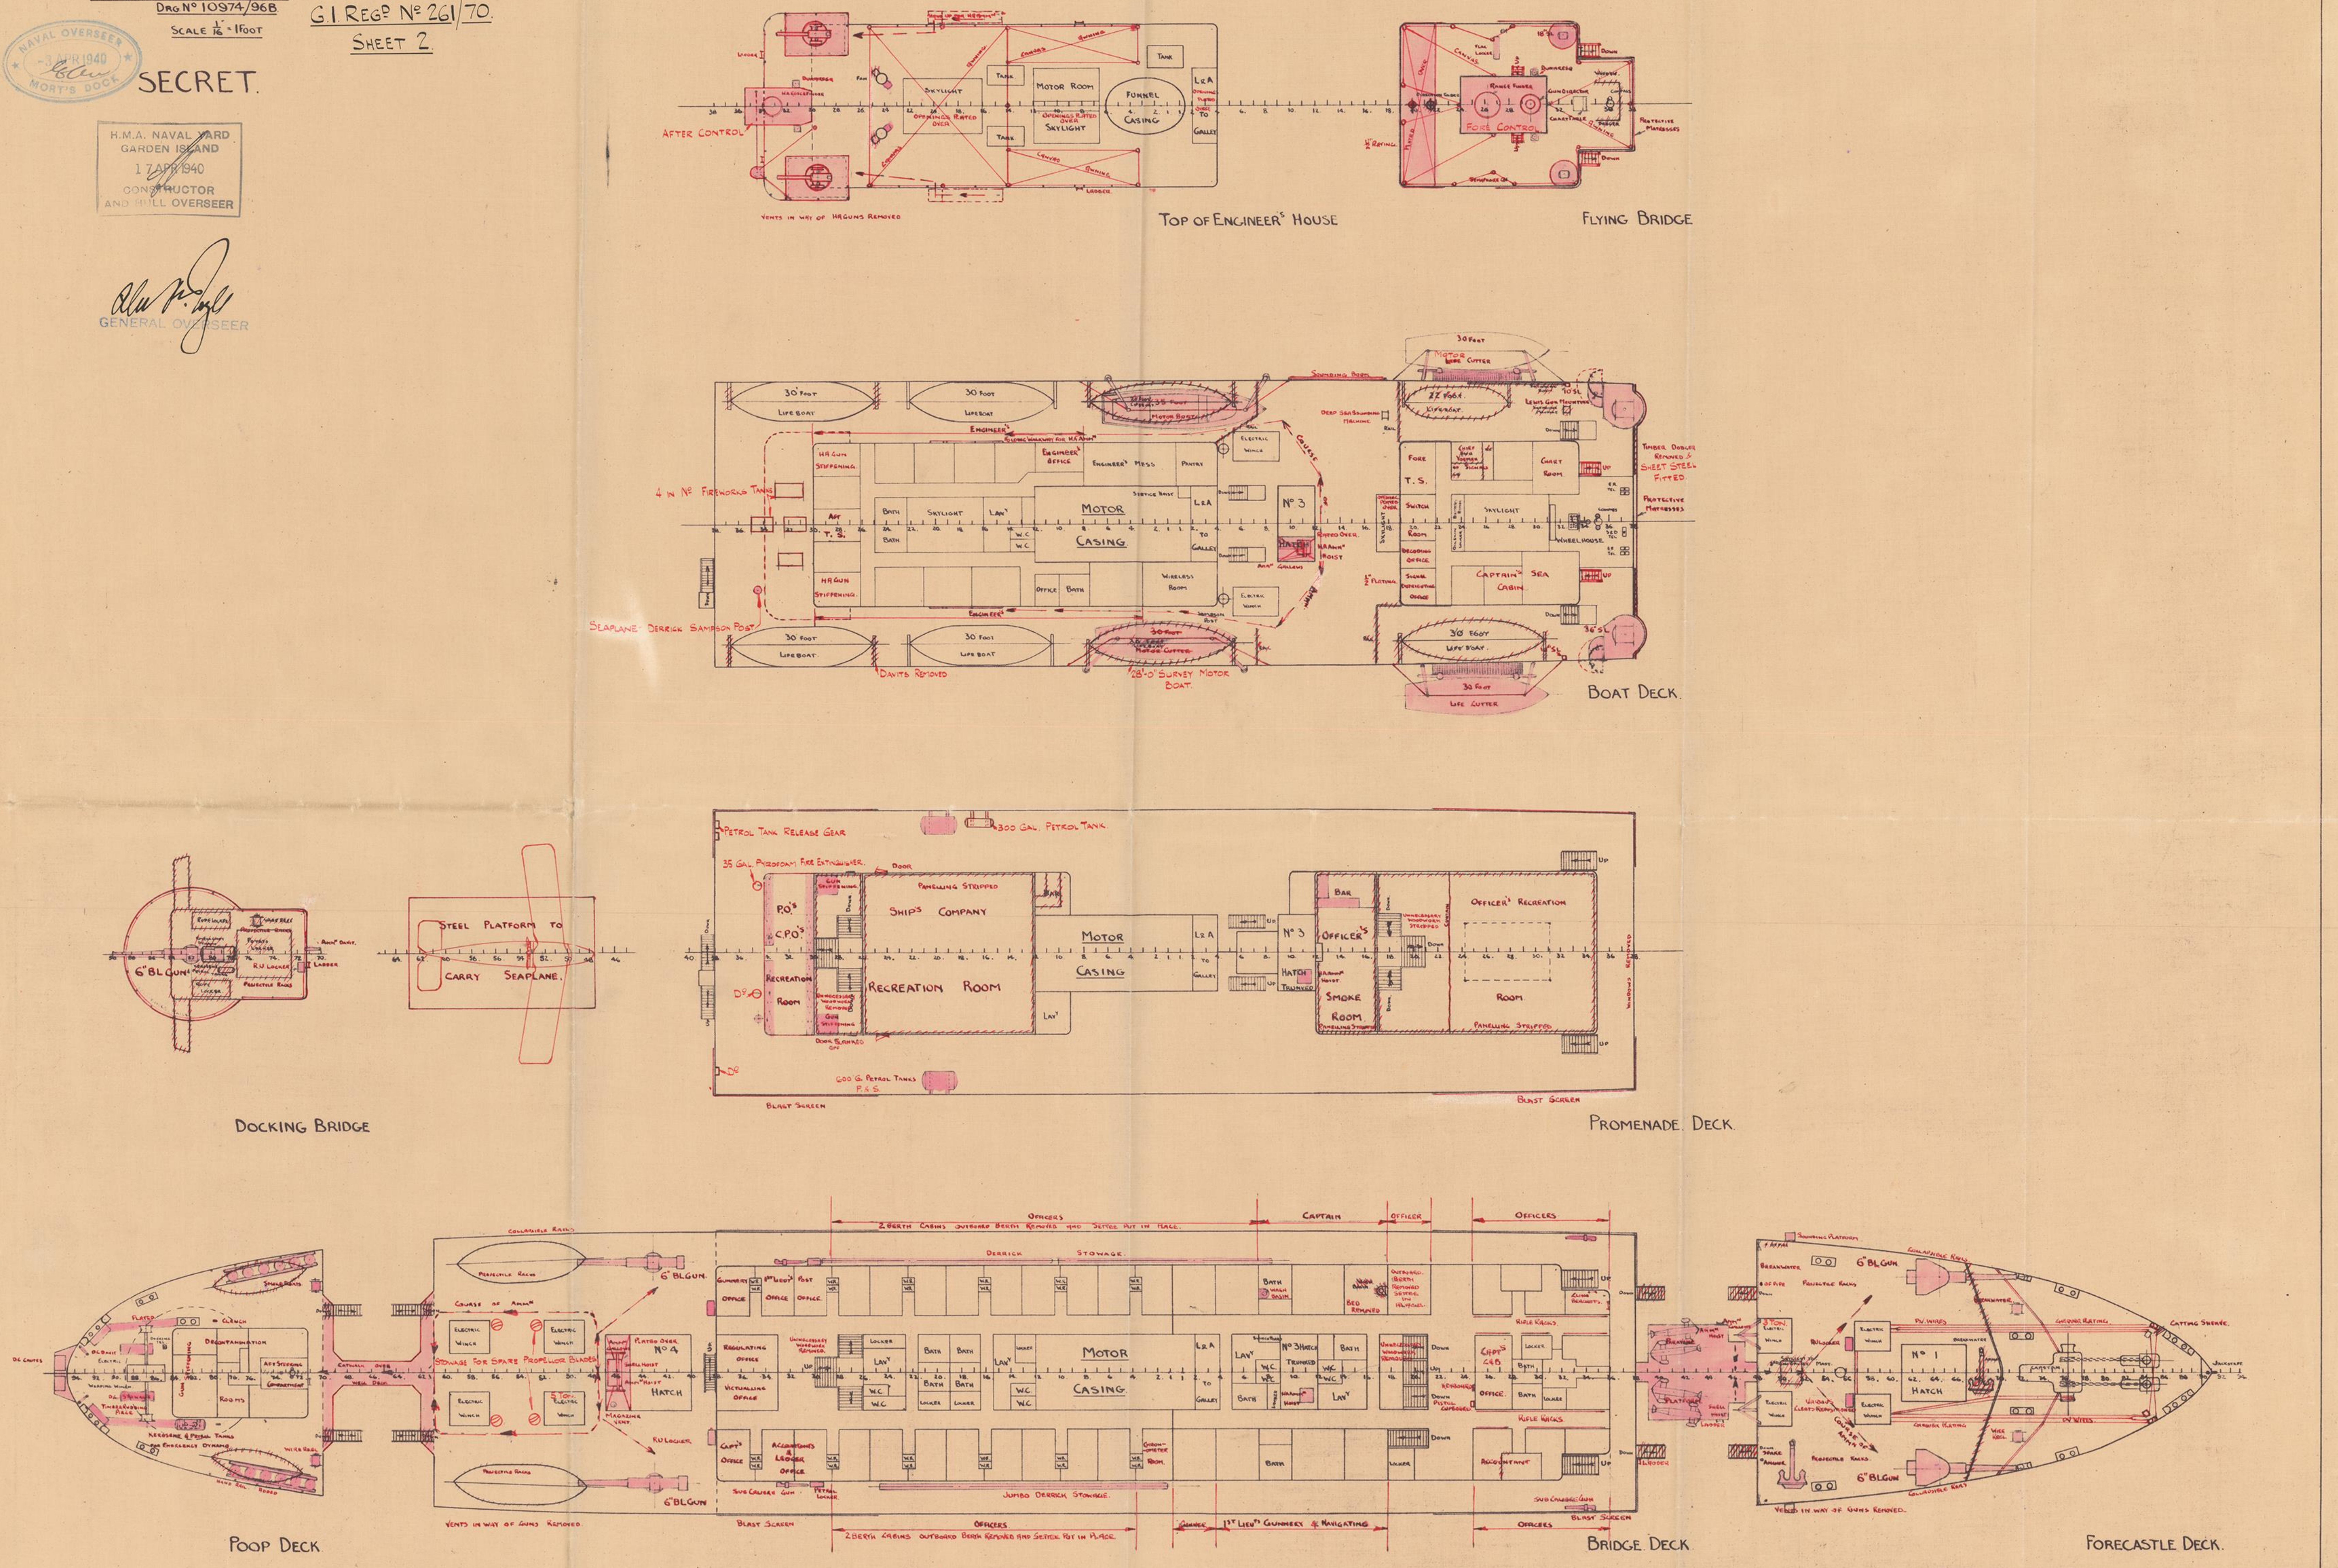


| | | | | | | |
|---|---|---|---|---|---|---|
| MORT'S DOCK & ENG Co Ltd SYDNEY | | | | | | |
| H.M.A.S. WESTRALIA | | | | | | |
| AS FITTED GENERAL ARRANGEMENT | | | | | | |
| ORDER No | DATE | APPROVED | DRAWN / TRACED / CHECKED | SCALE | DRAWING No | DRAWER |
| WESTRALIA. | 14 - 2 - 40 | | | 1/16" - 1FOOT | 10974/96B | 231. |

National Archives of Australia NAA: MP551/1, 120/135/11

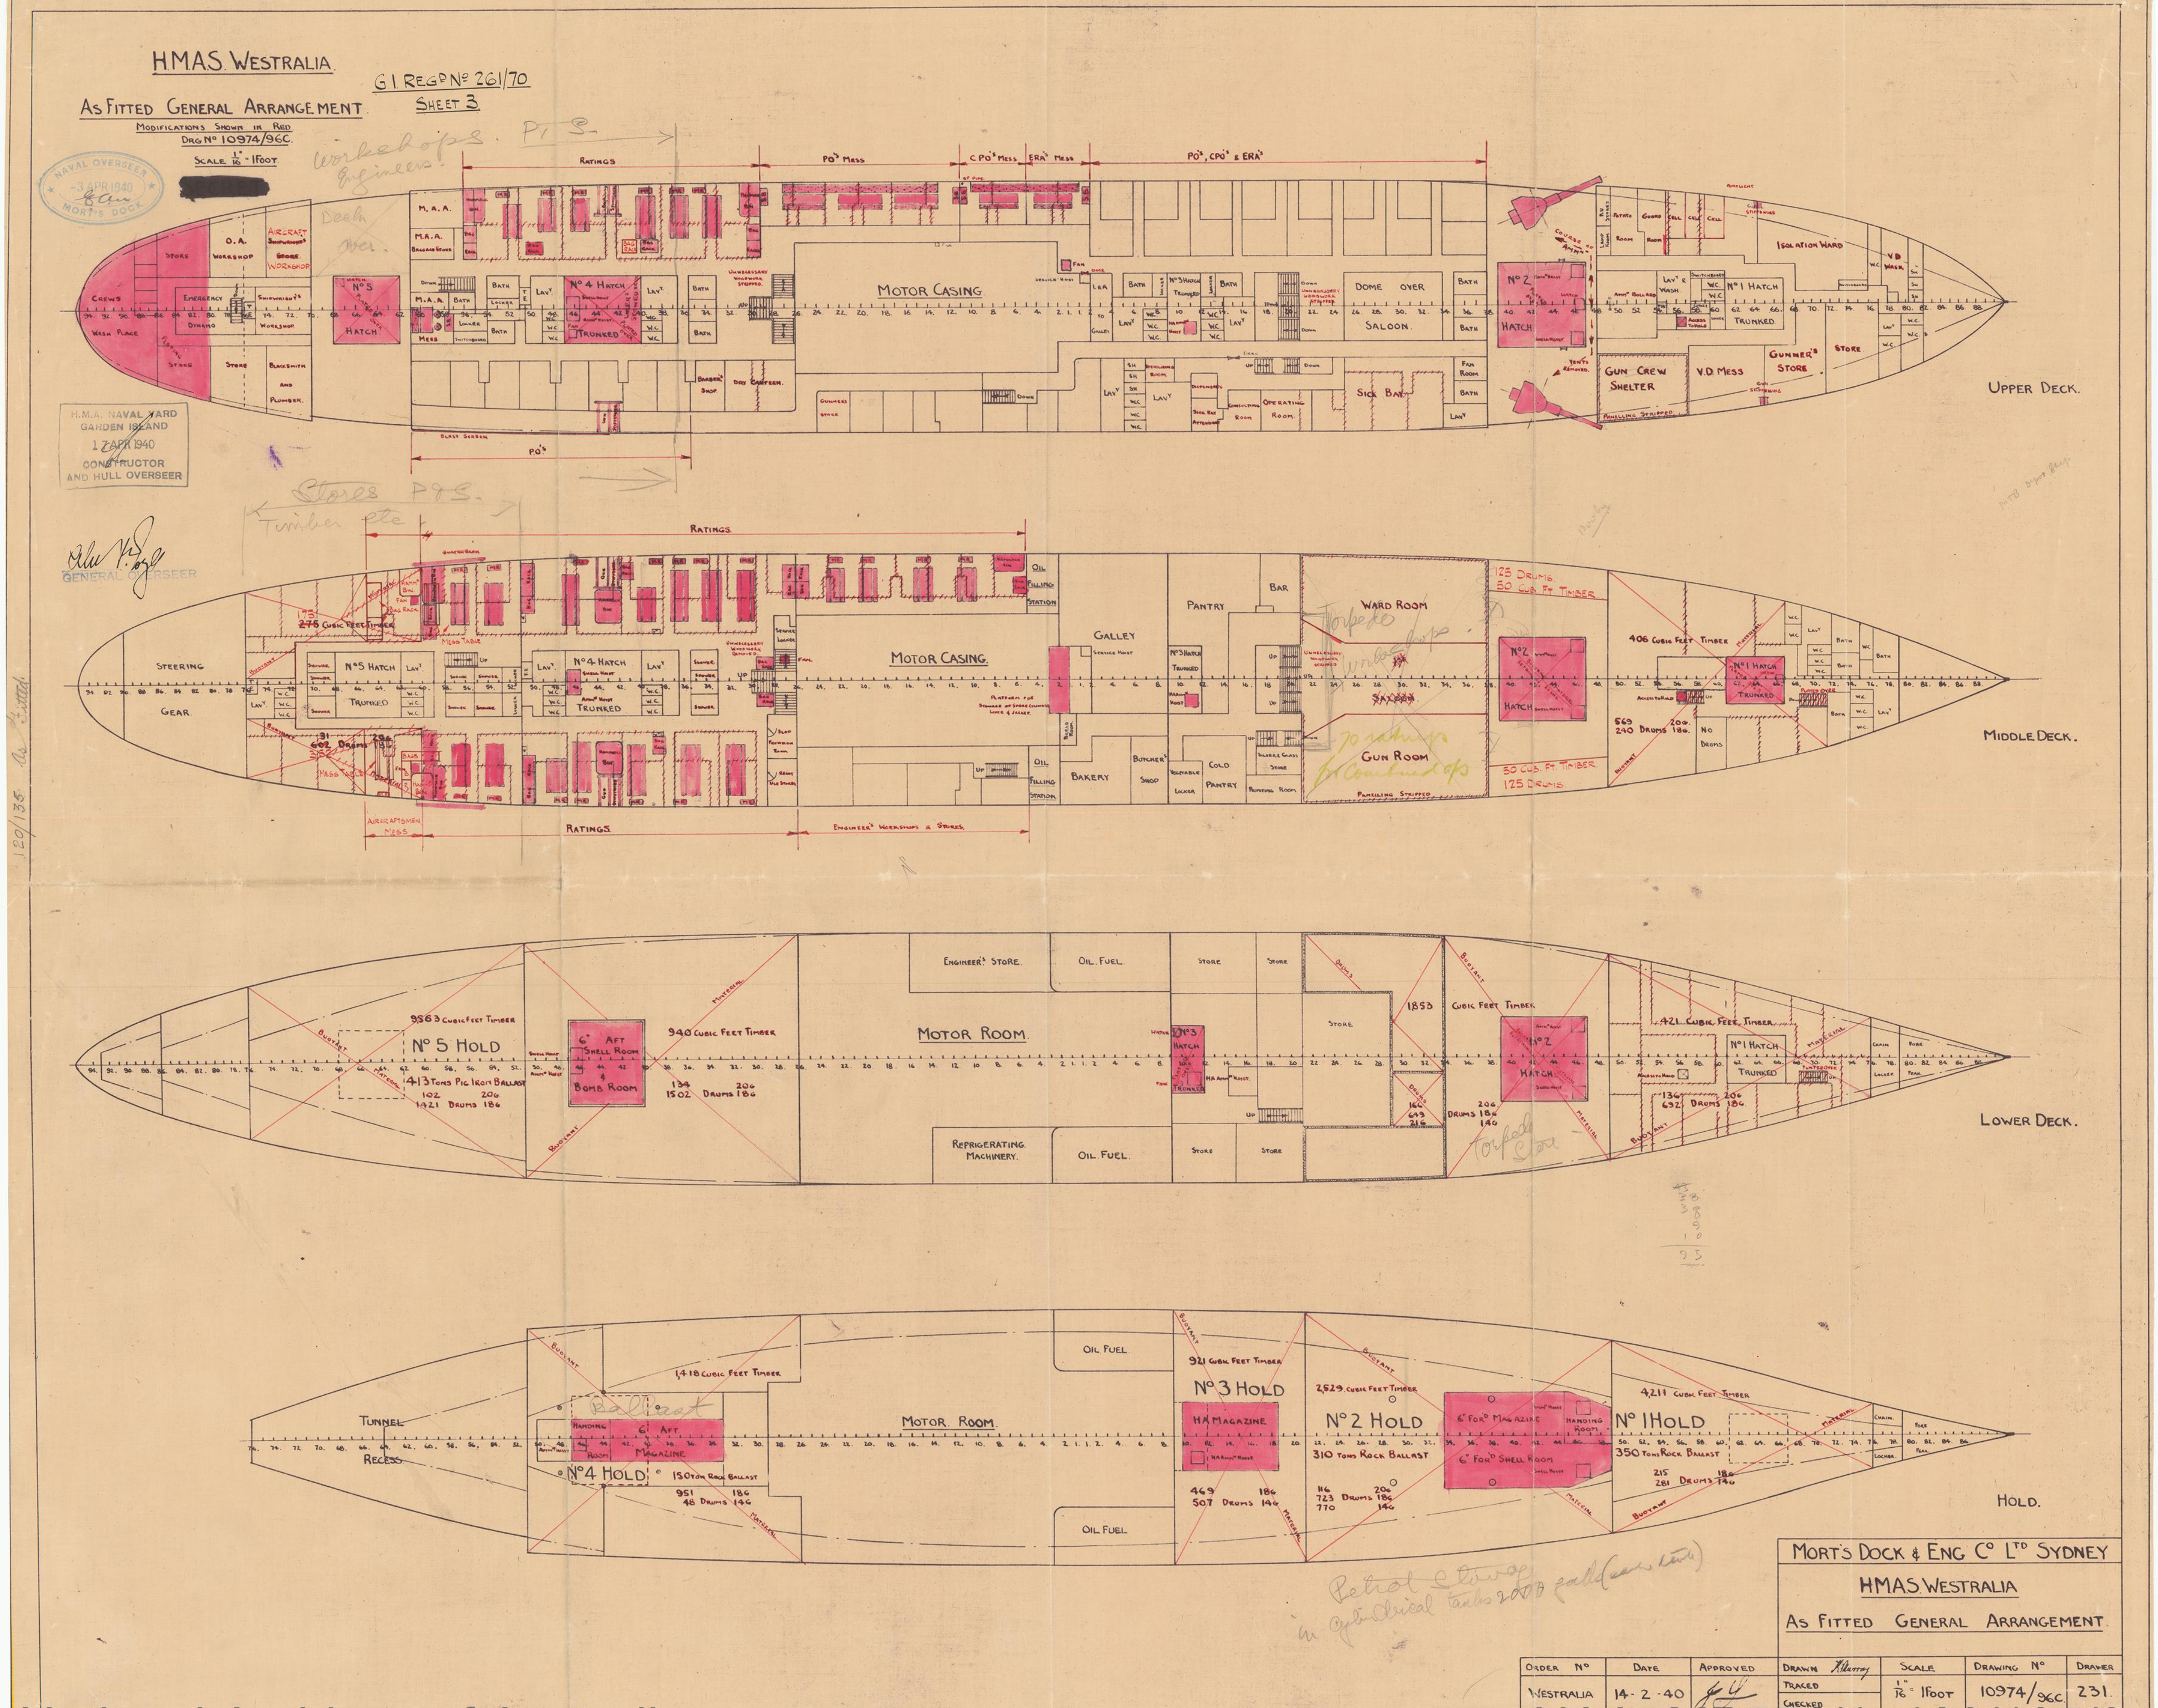


National Archives of Australia
NAA: MP551/1, 120/135/3

# H.M.A.S. WESTRALIA

**AS FITTED GENERAL ARRANGEMENT**

MODIFICATIONS SHOWN IN RED
DRG No 10974/96C

SCALE $\frac{1}{16}$" - 1 FOOT

G.I. REGD No 261/70
SHEET 3

**SECRET.**

NAVAL OVERSEER
-9 APR 1940
MORT'S DOCK

H.M.A. NAVAL YARD
GARDEN ISLAND
17 APR 1940
CONSTRUCTOR
AND HULL OVERSEER

GENERAL OVERSEER

120/135 As Fitted

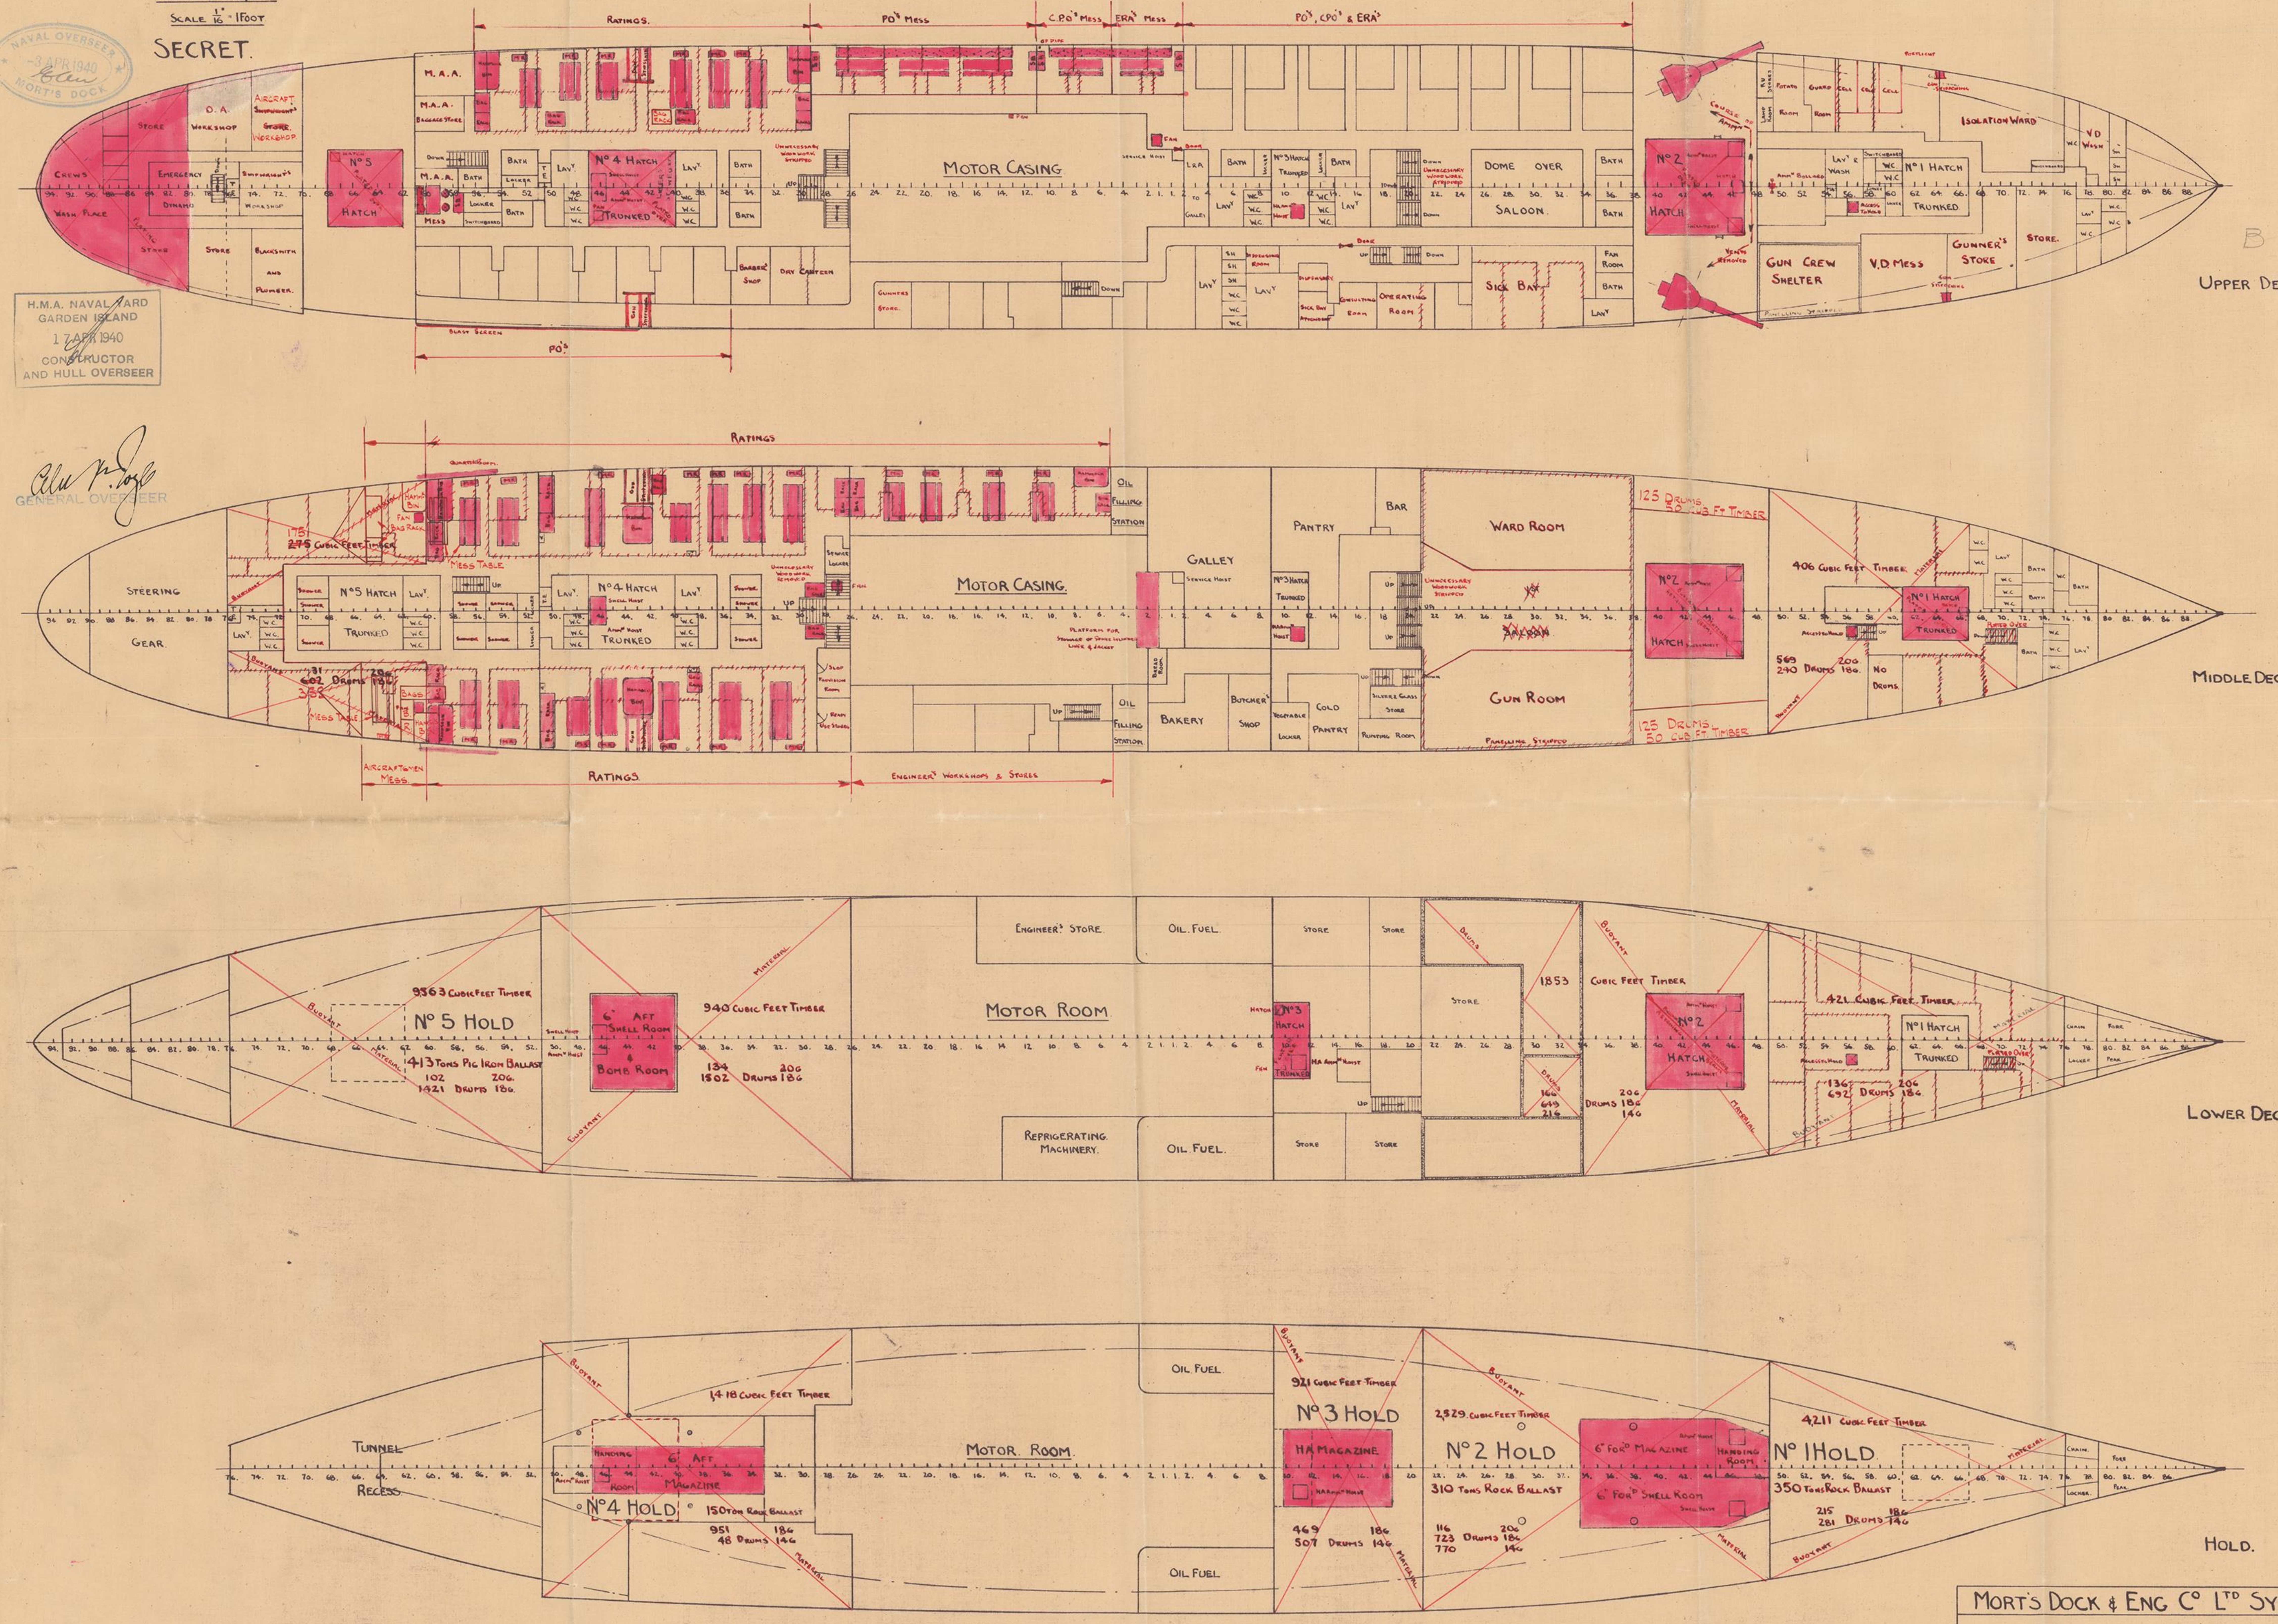


MORT'S DOCK & ENG Co LTD SYDNEY

H.M.A.S. WESTRALIA

AS FITTED GENERAL ARRANGEMENT

| ORDER No | DATE | APPROVED | DRAWN | SCALE | DRAWING No | DRAWER |
|---|---|---|---|---|---|---|
| WESTRALIA | 14-2-40 | [signature] | [signature] TRACED CHECKED | $\frac{1}{16}$" 1 FOOT | 10974/96C | 231 |

National Archives of Australia NAA: MP551/1, 120/135/10